


OPTION 2.1 NOTES

- REDEVELOPMENT OF EXISTING CHANGING AREA TO CREATE 2X NEW CHANGING ROOM AREA SPACES
- CHANGING SPACES TO COMPLY WITH MIN 16m² AREA
- ACCESS FROM CHANGING AREA TO MAIN HALL LOST
- CLEAR SPACE LEFT OUTSIDE BOILER ROOM

KEY

- DEMOLISH LINE
- █ EXISTING WALL
- ▨ NEW PARTITION WALL
- ▩ NEW EXTERNAL WALL

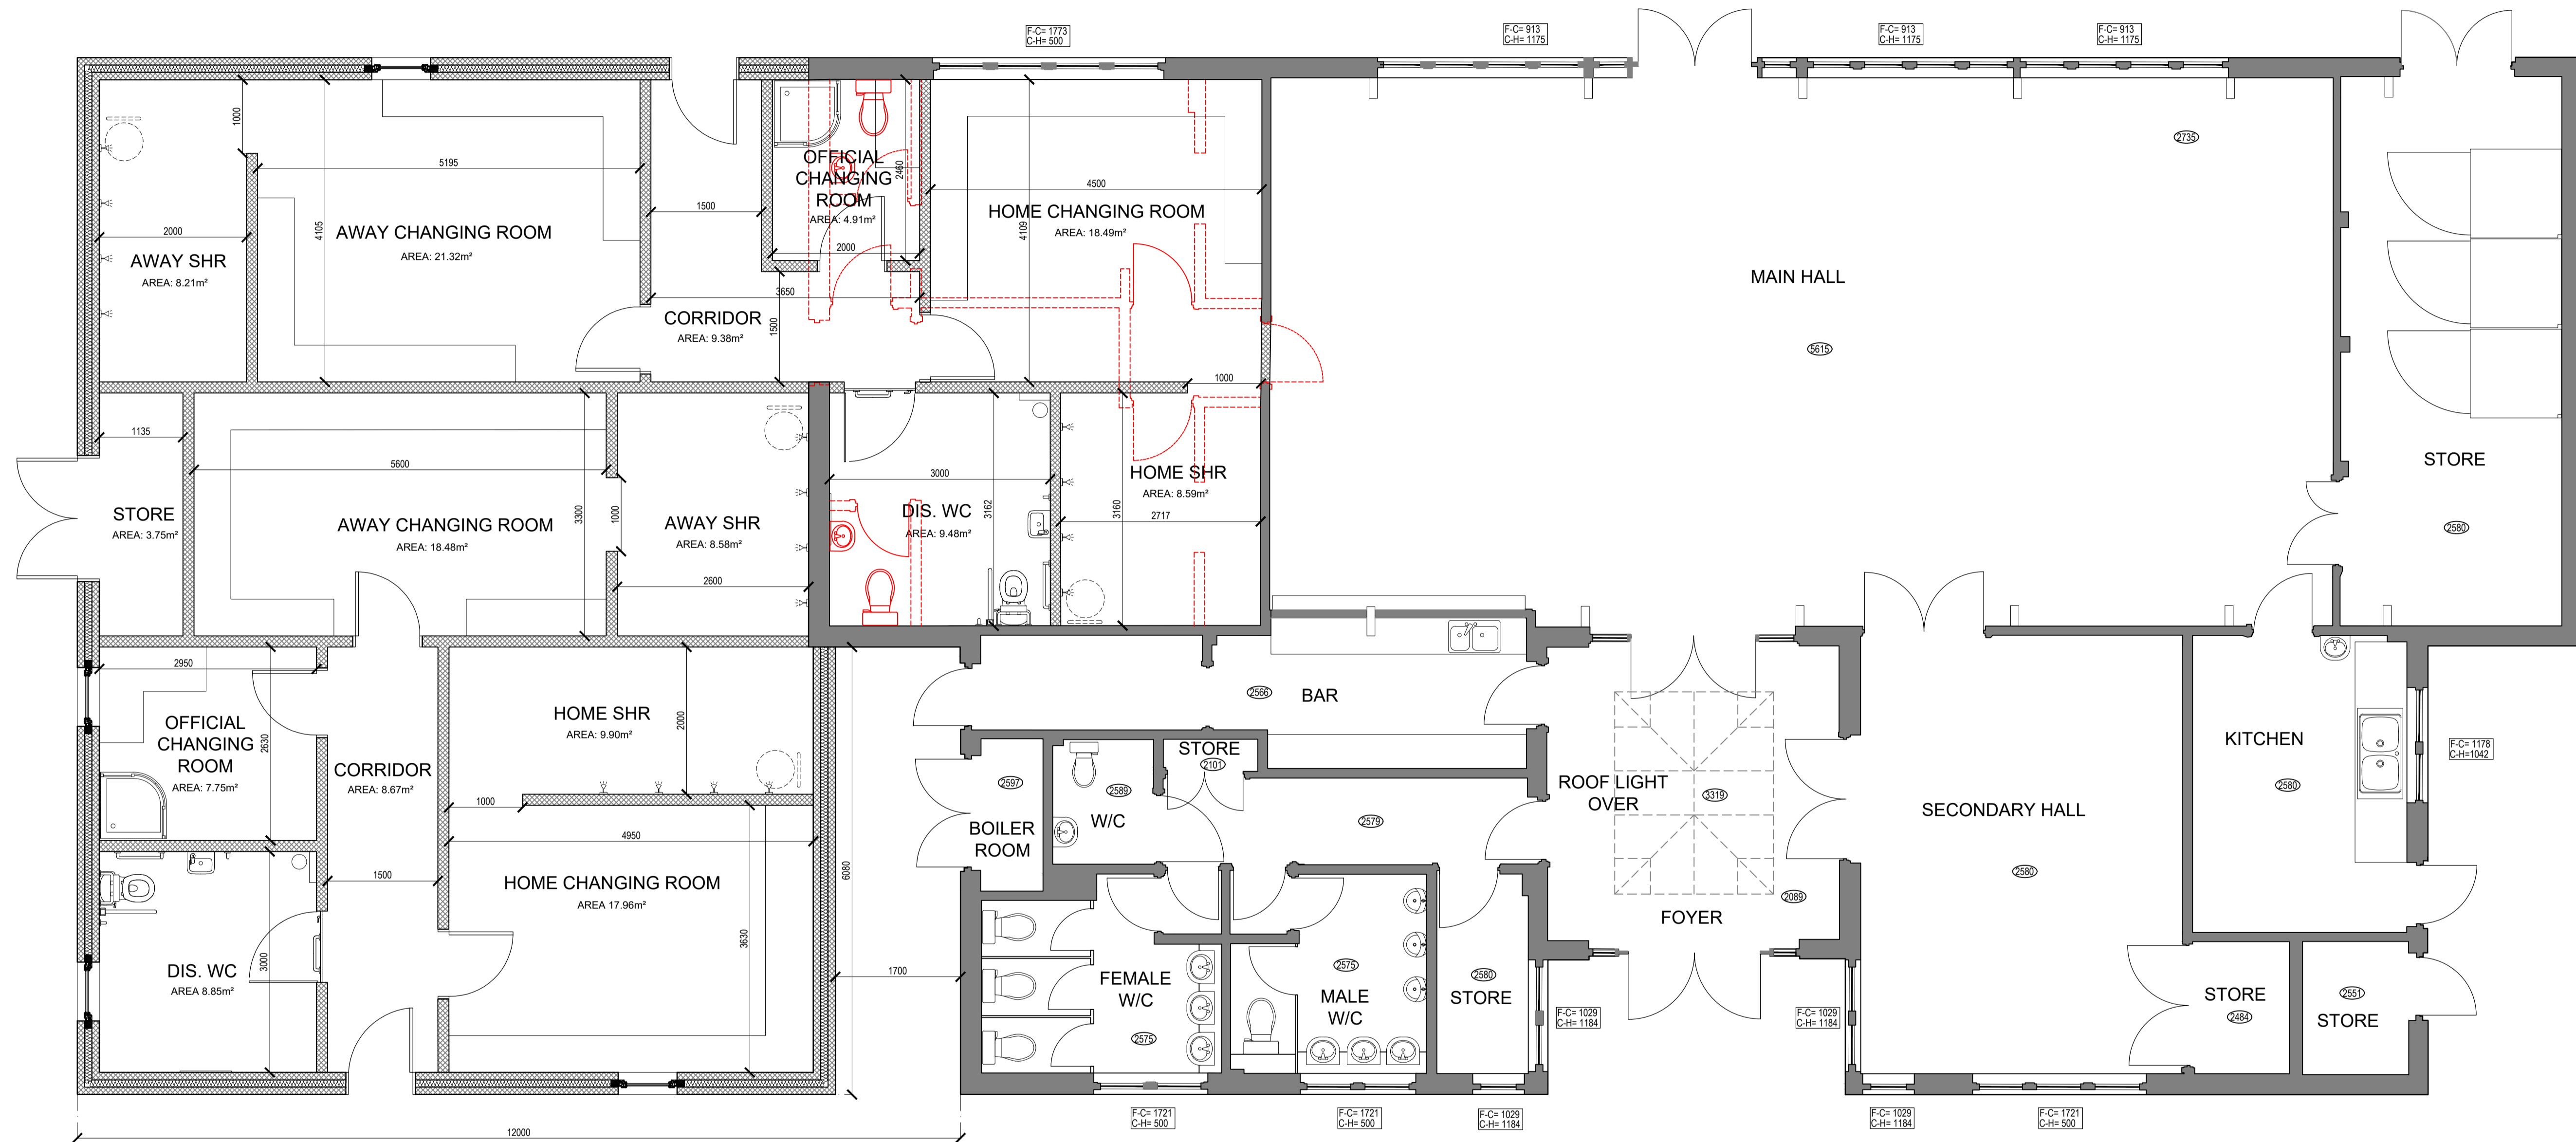

GROUND FLOOR PLAN
SCALE @ 1:50



DISCLAIMER NOTES:

- THIS DOCUMENT IS COPYRIGHT OF THE ORIGINATOR AND MUST BE TREATED AS CONFIDENTIAL.
- THIS DOCUMENT MUST NOT BE ALTERED, REPRODUCED OR DISTRIBUTED WITHOUT PRIOR WRITTEN CONSENT OF THE ORIGINATOR.
- THIS DOCUMENT IS AVAILABLE IN BOTH CONTROLLED (eg. pdf) AND UNCONTROLLED (eg. dwg) FORMATS. UNCONTROLLED FORMATS MUST NOT BE ALTERED - THE ORIGINATOR ACCEPTS NO RESPONSIBILITY FOR ANY DISCREPANCIES ARISING AS A RESULT OF THE ORIGINATOR'S INFORMATION BEING ALTERED BY OTHERS.
- ANY DISCREPANCY MUST BE REPORTED TO THE ORIGINATOR.
- DO NOT SCALE THIS DOCUMENT - USE FIGURED DIMENSIONS ONLY.
- ALL DIMENSIONS MUST BE CHECKED ON SITE PRIOR TO COMMENCEMENT OF ANY RELATED WORKS.
- THIS DOCUMENT MUST BE READ IN CONJUNCTION WITH ALL SUPPORTING DOCUMENTS PRODUCED BY THE ORIGINATOR AND OTHER PROJECT DISCIPLINES.
- THE ORIGINATOR ACCEPTS NO RESPONSIBILITY FOR THE ACCURACY OF BACKGROUND INFORMATION PRODUCED BY THIRD PARTIES - THIS MUST BE TREATED AS INDICATIVE ONLY.
- USERS OF THIS DOCUMENT ARE RESPONSIBLE FOR CHECKING WHICH REVISION IS CURRENT.
- THE DOCUMENT STATUS: 'PRELIMINARY' INDICATES THAT THIS DRAWING IS FOR REFERENCE PURPOSES ONLY - THE ORIGINATOR WILL ACCEPT NO RESPONSIBILITY FOR THE COMPLETENESS OF INFORMATION UNDER THIS STATUS.
- THE DOCUMENT STATUS: 'RECORD' OR 'AS BUILT' HAS BEEN PREPARED, IN PART, BASED UPON INFORMATION FURNISHED BY OTHERS. WHILE THIS INFORMATION IS BELIEVED TO BE RELIABLE, THE ORIGINATOR ASSUMES NO RESPONSIBILITY FOR THE ACCURACY OF THIS 'RECORD' OR 'AS BUILT' DOCUMENT OR FOR ANY ERRORS OR OMISSIONS THAT MAY HAVE BEEN INCORPORATED INTO IT AS A RESULT OF INCORRECT INFORMATION PROVIDED TO THE ORIGINATOR. THOSE RELYING ON THE 'RECORD' OR 'AS BUILT' DOCUMENT ARE ADVISED TO OBTAIN INDEPENDENT VERIFICATION OF ITS ACCURACY.

DRAWING NOTES:

CDM REGULATIONS 2015
SIGNIFICANT OR NON-OBSVIOUS RISKS AND RISKS WHICH ARE DIFFICULT TO MANAGE ARE IDENTIFIED ON THIS DRAWING USING THE FOLLOWING SYMBOL IDENTIFIED TO THE RIGHT WITH BRIEF ACCOMPANYING TEXT. FOR FURTHER DETAILS OF THE RISKS IDENTIFIED BY DESIGNERS, REFERENCE SHOULD BE MADE TO CDM HAZARD REGISTER.

CLIENT:
WITNEY TOWN COUNCIL

IN ASSOCIATION WITH:

PROJECT:
**BURWELL HALL
WITNEY - OX28 5NP**

TITLE:
PROPOSED GROUND FLOOR PLAN

OPTION 2.1

DRAWN BY: DS SCALE: 1:50 @ A1
CHECKED BY: LR DATE: 22/08/2022

STATUS:
INFORMATION

DRAWING No: -
PROJECT: 5018894 ORG: RDG ZONE: XX LEVEL: XX TYPE: PL ROLE: B NUMBER: 0101 REV: -

ORIGINATOR:

RIDGE
PROPERTY & CONSTRUCTION CONSULTANTS

THE COWYARDS
BLENHHEIM PARK
OXFORD ROAD
WOODSTOCK, OX20 1OR

TEL: 01993 815000
WWW.RIDGE.CO.UK

REV	DESCRIPTION	DATE	BY	CHKD
-	-	00/00/2015	XX	XX